


OLD FLOOR PLAN

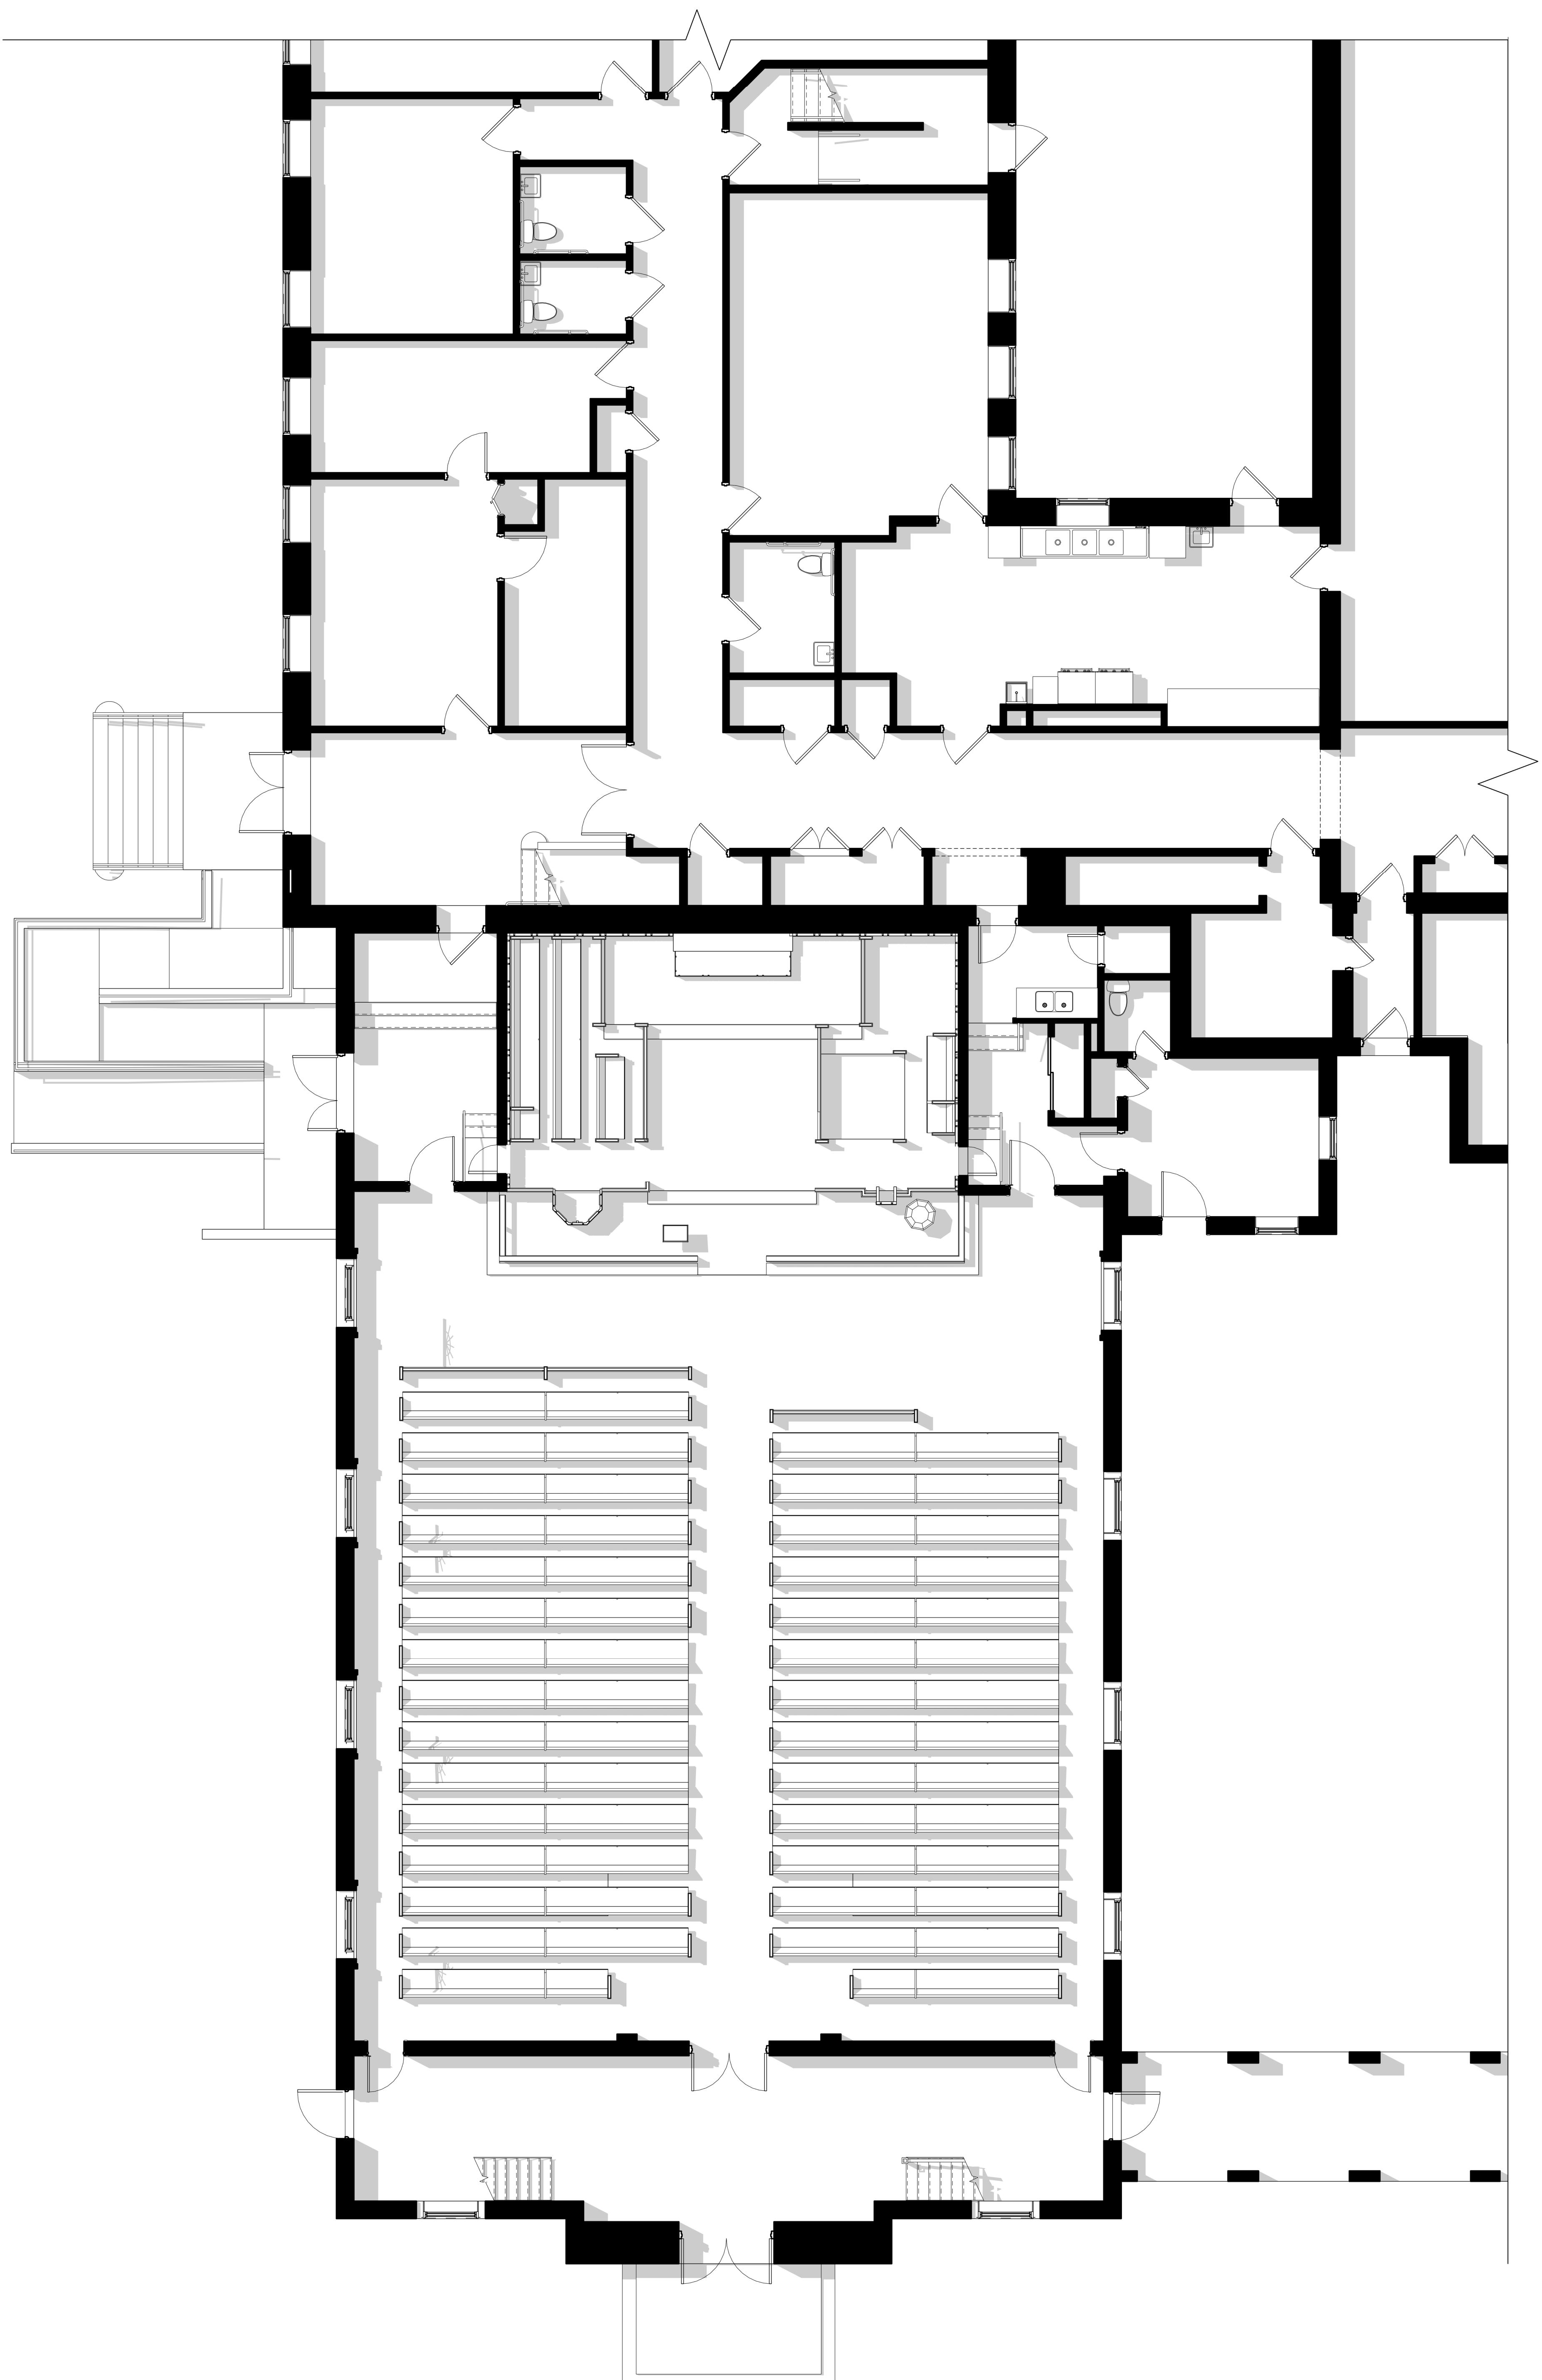

FIRST FLOOR RECORD PLAN

3/16" = 1'-0"

0' 5'-4" 10'-8" 16'